
Site Plan

Scale 1:150

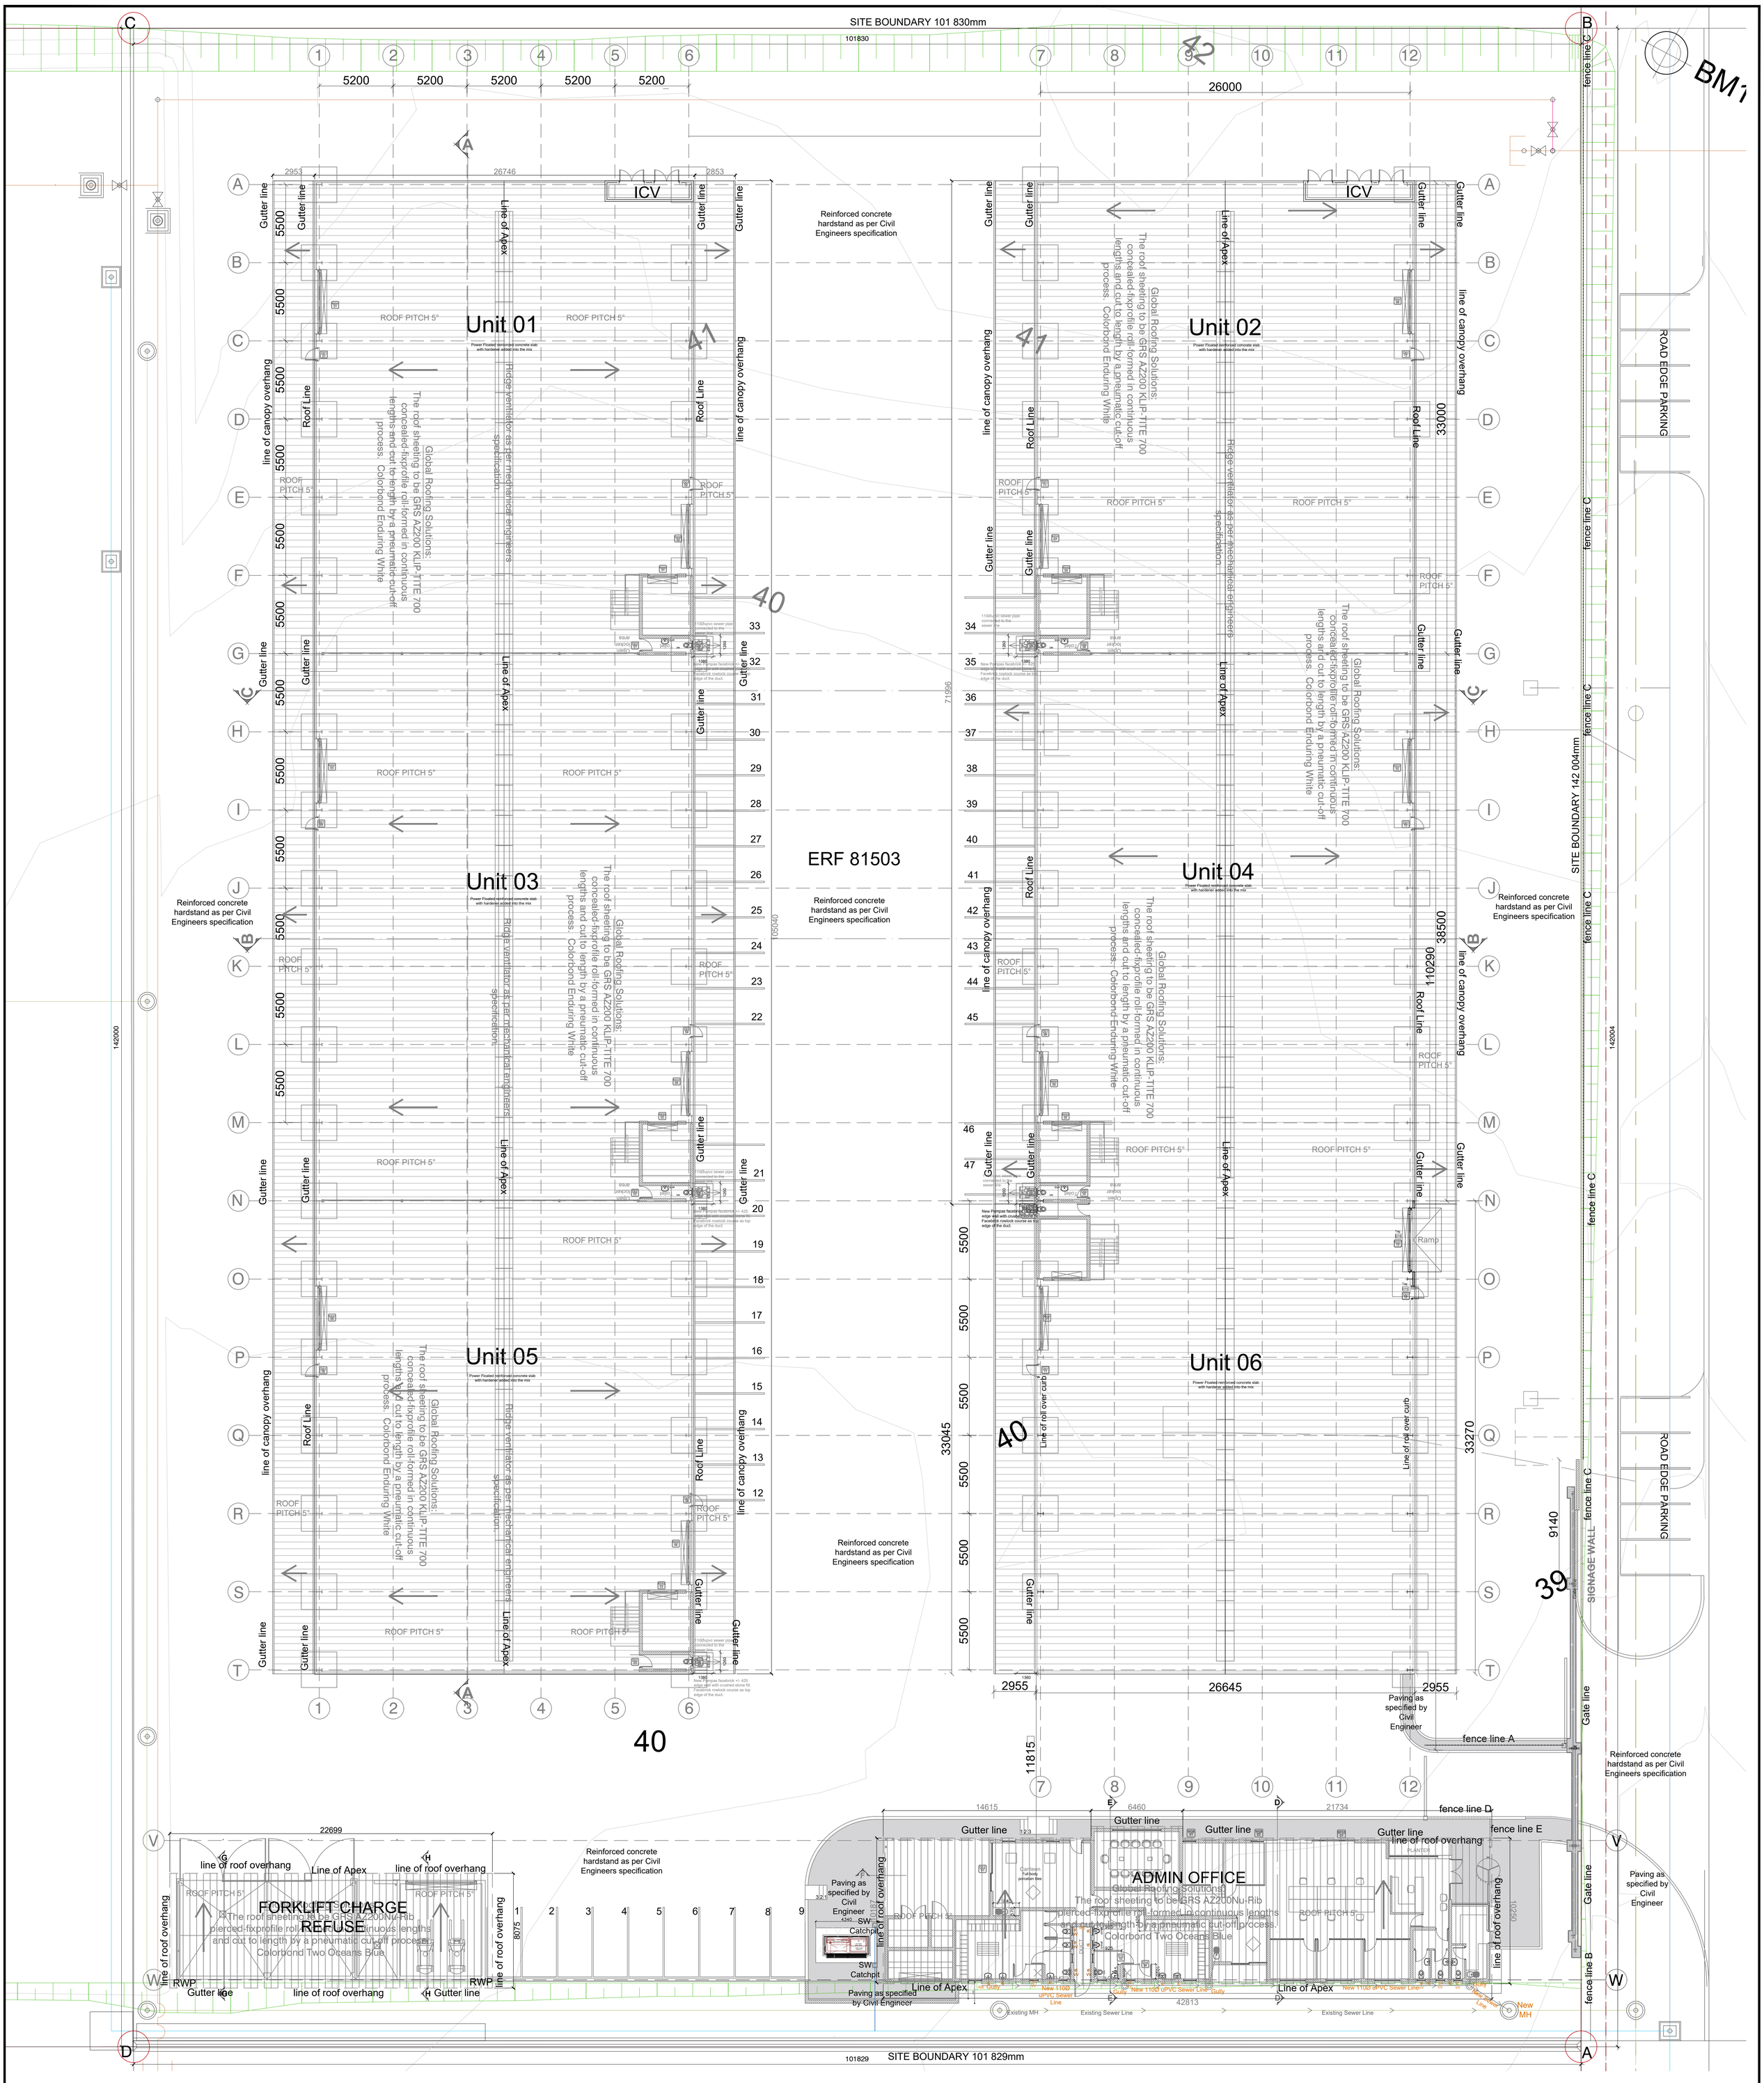

General Notes:

- All dimensions and levels are to be checked on site by the Contractor and discrepancies must be reported to the Architect before any work commences.
- This drawing is to be read in conjunction with all other drawings including those of Consultants and/ or Bills of Quantities and/or specification issued for this project.
- Scaled dimensions are not to be used for construction. Should there be any discrepancies or lack of dimensions the Architects are to be contacted for clarification.
- Only drawings numbered 200 and upwards and showing the latest revisions are to be used for construction. All previously issued drawings are to be destroyed.
- The Architects reserve the copyright on this drawing.
- This drawing is only to be used for the project and site for which it was prepared.
- No setting out is to commence before the positions of the boundary pegs on the site have been verified by a Land Surveyor.
- Sewer connection to comply with municipal regulations

PROJECT TEAM

Project Managers:

Engineering Advice & Services
73 Heugh Road
Walmer, Port Elizabeth
T - 041 581 2421
C - 082 787 9976
Marcus Niemand
marcus@easpe.co.za

Principal Agent / Architect:

MDA Architects
17 Bonza Bay Road
Beacon Bay, East London
T - 043 748 1391
C - 082 774 1383
Pat Dalgleish
pat@mdaarchitects.co.za

Quantity Surveyors:

MMPA Quantity Surveyors and Project managers
14 Bonzabay Road, Beacon Bay
East London 5241
T - 043 721 0077
C - 079 990 6589
James Brown
james@mmpaqs.co.za

Structural Engineers:

HSC Consulting Engineers
18 St Marks Road, Southernwood.
East London 5213
T - 043 743 9528
C - 074 637 4939
Andrew Scott
andrew@hscc.co.za

Civil Engineers:

Engineering Advice & Services
73 Heugh Road
Walmer, Port Elizabeth
T - 041 581 2421
C - 083 300 3047
Siyabonga Bana
siyab@easpe.co.za

Electrical & Mechanical Engineers:

Kuyaduduma Consulting Engineers
30East Bend Road, Beacon Bay,
East London 5241
T - 043 748 5711
C - 082 464 6738
Dean Posthumus dean@kceng.co.za

Drawing Revisions:

Revision	Date	Drawn By	Description	Revision	Date	Drawn By	Description

Discipline
ARCHITECT:
MDA Architects

Project Title
ELIDZ: EB/INCU/11/21/Z1B
Incubator Facility

Drawing Name
RECORD DRAWINGS:
SITE PLAN

Client Approval

Client:
east london idz
business streamlined

Issue Date:	26.08.2024
Technician:	AF
Checked By:	P.J.D
Drawing Scale:	as shown

Drawing Number: **EE1-AR-1100**
Page Size: A0
Revision: --

ISSUED FOR: AS-BUILT